LETTER CODE	CABLE DIAMETER RANGE (INCHES)	CABLE TYPES	REFERENCE CABLE GROUP: TOP-CUT	REFERENCE CABLE GROUP: SLANT-CUT
A	.070 / .110	RG-174, RG-316, RG-316, RG-178, RG-179, RG-179/U 00001	-.001 -.004	-.5 -.5A
I	.110 / .160	CD 100, AT&T 223A,DC,00A 8210, 121 SEMI-FLEXIBLE (TOP) RG-8000	-.001 -.003 -.030	-.4 -.5A -.5B
B	.160 / .210	RG-58, RG-58, RG-58A, RG-58C, RG-302, RG-142/178 00001 (LIMITED ROOTS)	-.011 -.012	-1 -.01
C	.210 / .250	RG-165, RG-141, RG-400, RG-11/U-P	-.011 -.013	-1
D	.250 / .270	RG-59, RG-59A, RG-6, RG-6A, RG-62A, AT&T 224A, 59-62	-.013 -.014 -.018 -.019 -.025	-2 .50
E1	.271 / .305	RG-11 (SP 142), AT&T 320 AND AT&T 270	-.015	-8
E2	.271 / .305	RG-11 (FOAMED & SOLID)	-.018	5
F A	.300 / .430	RG-6, RG-11, RG-17A, RG-214 (FOAMED)	.....	.5A -.5B

ITEM NUMBER	PART NO. NORTH & SOUTH AMERICA	PART NO. EUROPE	PART NO. UNITED KINGDOM
AC POWER CONVERTER	ACS-NA	ACS-EU	ACS-UK
AC CHARGER FOR NI-CAD BATTERY	BCS-NA	BCS-EU	BCS-UK
AUTO 12V DC CHARGER CORD FOR NI-CAD BATTERY	BCC	[illegible]	[illegible]
EXTRA RECHARGEABLE BATTERY PACK METER READER	BCP-NA	BCP-EU	BCP-UK

REDLINE ALL THIS DRAWING SHOULD BE PERFORMED IN CONFORMANCE WITH THE ISO 9001 QUALITY SYSTEM. NO MODIFICATIONS SHALL BE MADE WITHOUT ENGINEERING APPROVAL. ANY MODIFICATION MUST BE PERFORMED IN ACCORDANCE WITH THE ENGINEERING CHANGE NOTICE PROCEDURE.

REVISIONS

REV	DESCRIPTION
G	REVISED PER ECO 15174

010-0083 | SHT 1

DATE 6/12/06 | APPROVED MCS

RED INDICATES ORIGINAL

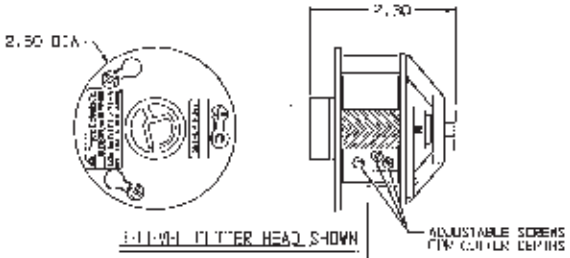

3-LEVEL CUTTER HEAD SHOWN

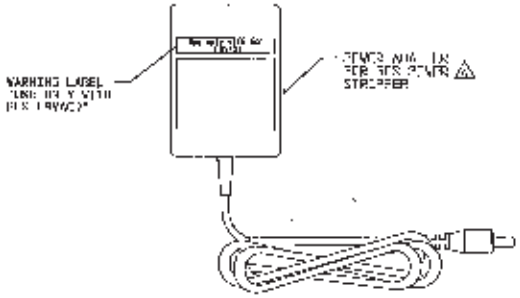

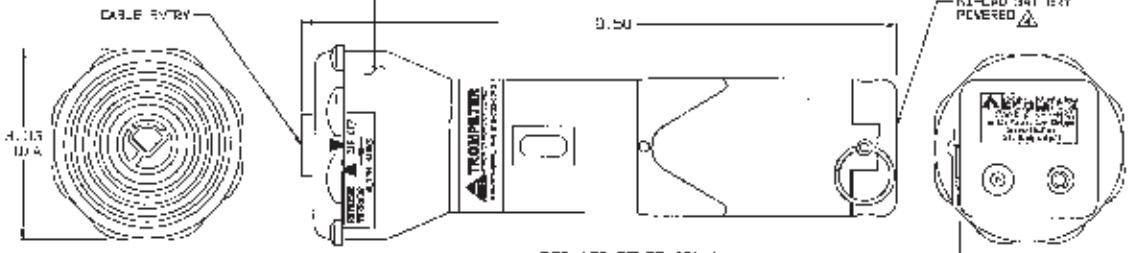

BCS/ACS POWER STRIPPER

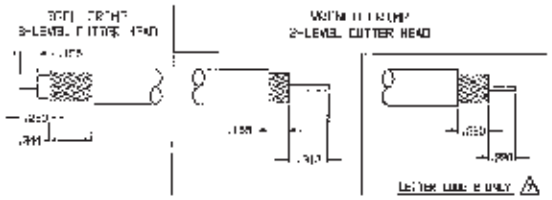

STRIPPING DIMENSIONS

SCALE: NONE

⚠ SEE SPECIAL STRIPPING DIMENSIONS

6. EACH ITEM MAY BE SOLD SEPARATELY
5. EACH KIT IS SUPPLIED WITH A 12.5 X 9.5 X 5.4 CARRYING CASE AND USER INSTRUCTIONS

⚠4 INDIVIDUAL BATTERY OR OPTIONAL POWER SOURCE MAY BE ORDERED AS SHOWN FOR TABLE 2

3. EXAMPLE OF COMPLETE ORDER NO.

BCS / C24T 3 A

- A = CABLE GROUP LETTER CODE USE TABLE 1
- 3 = 3-LEVEL FOR TOOL CRIMP; 2 = 2-LEVEL FOR VARIOUS CRIMP
- C24T = CUTTER HEAD BASIC PART NO.
- BCS = POWER STRIPPER TOOL:
  - BCS = NI-CAD BATTERY WITH AC & DC CHARGER FOR NORTH & SOUTH AMERICA
  - BCS = NI-CAD BATTERY WITH AC & DC CHARGER AND RAPID CHARGER FOR NORTH & SOUTH AMERICA
  - BCS-EU = NI-CAD BATTERY WITH AC & DC CHARGER FOR EUROPE
  - BCS-UK = NI-CAD BATTERY WITH AC & DC CHARGER FOR UNITED KINGDOM
  - ACS = AC POWER CONVERTER FOR NORTH & SOUTH AMERICA
  - ACS-EU = AC POWER CONVERTER FOR EUROPE
  - ACS-UK = AC POWER CONVERTER FOR UNITED KINGDOM

2. PORTABLE, HAND HELD, POWERED COAX CABLE STRIPPER KIT WITH AND WITHOUT CUTTER HEADS, WITH OPTIONAL POWER SOURCES. SEE TABLE 2
1. ALL DIMENSIONS IN INCHES

DRAWN	6/9/06	TROMPETER RF connectivity (a cinch connectivity solutions brand)	
CHECKED	6/12/06	TITLE: BCS/ACS POWER STRIPPING TOOL	
SIZE A	CAGE CODE 14949	DRAWING NO. 010-0083	REV. G
SCALE NONE	DATE 10-16-03	SHT 1 OF 1	